


Kids' Bedrooms

As-built:

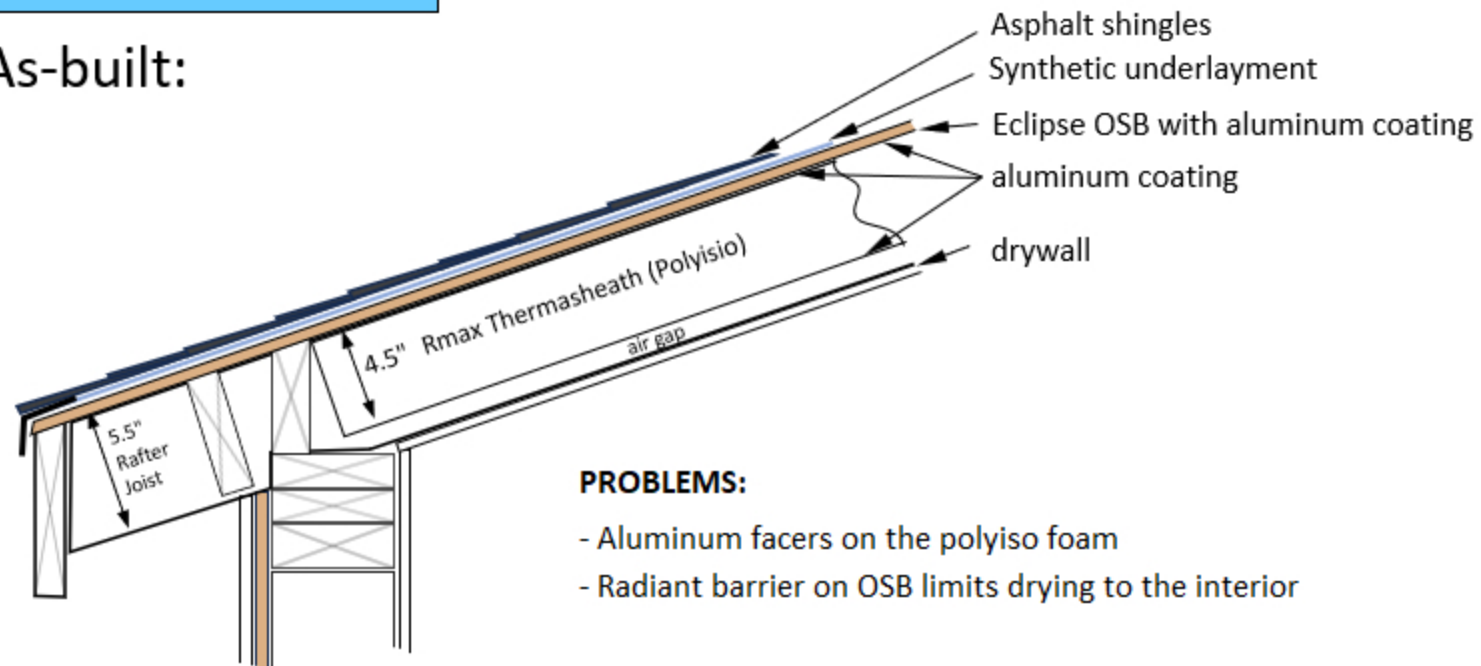


PROBLEMS:

- Aluminum facers on the polyiso foam
- Radiant barrier on OSB limits drying to the interior




1. From the top:

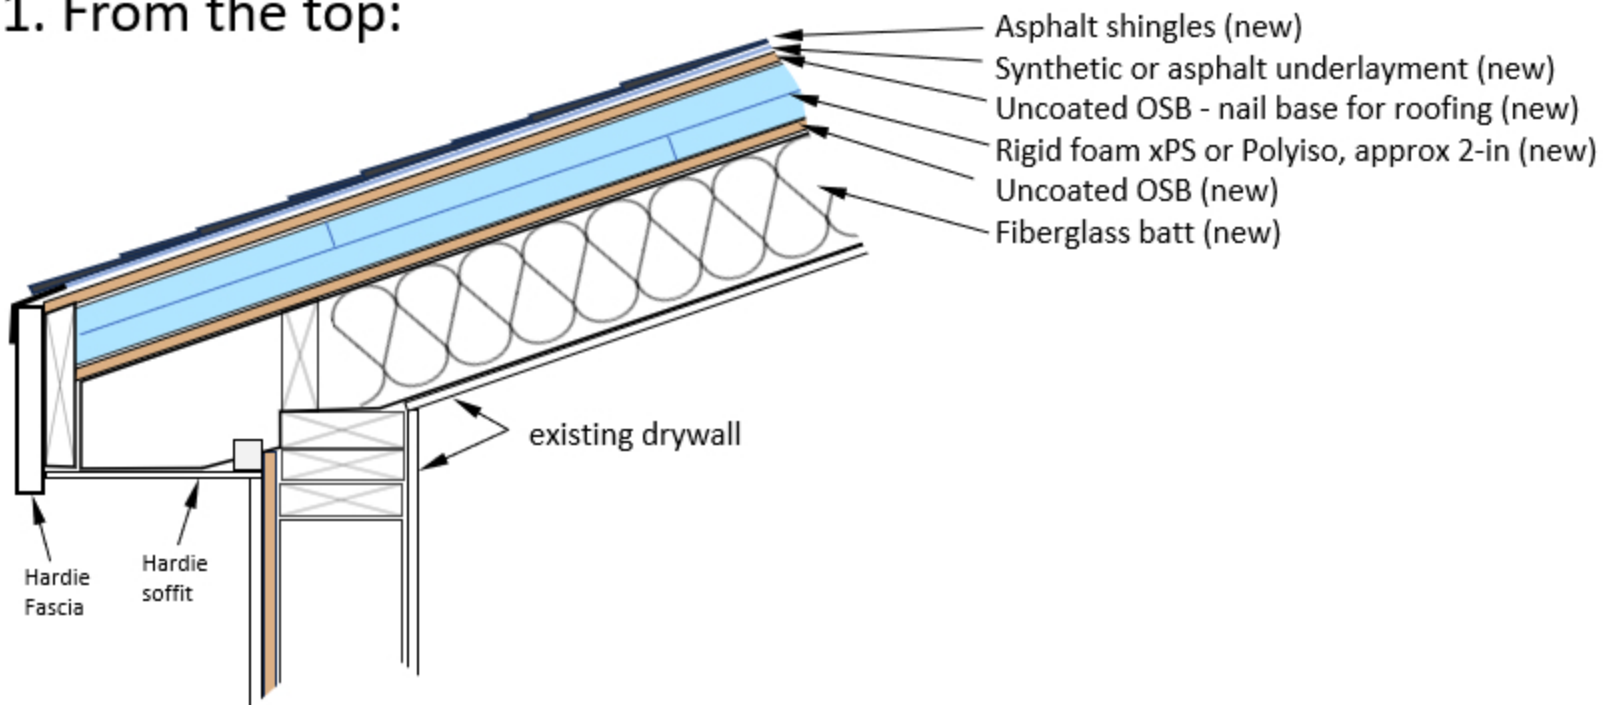

Other Vaulted Ceiling Areas

As-built:

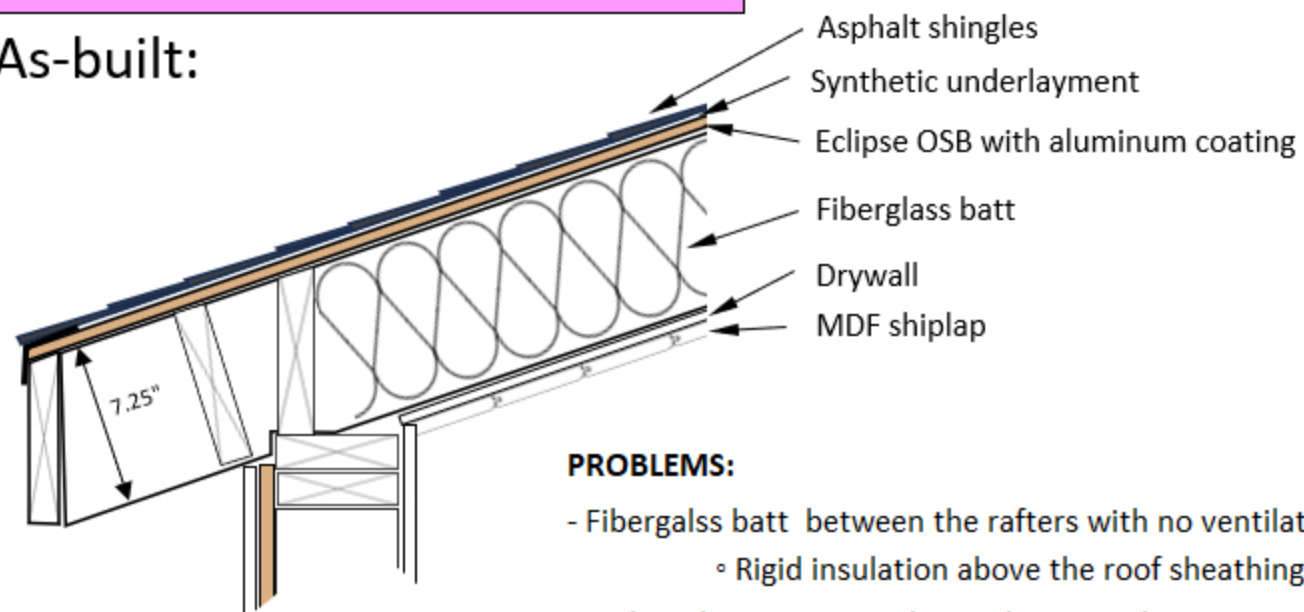

PROBLEMS:

- Fiberglass batt between the rafters with no ventilation also requires:
 - Rigid insulation above the roof sheathing: CRC R806.5 - 5.1.2.
- Radiant barrier on OSB limits drying to the interior
- R-value is approximately 25 for this area (R-30 requirement)



1. From the top:

